



D. 19982 Sheet 1 of 2

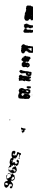

NOTE 2: SURVEY BASED ON FIELD LOCATIONS MADE IN 1977 AND 1979.

12/7/89 DATE

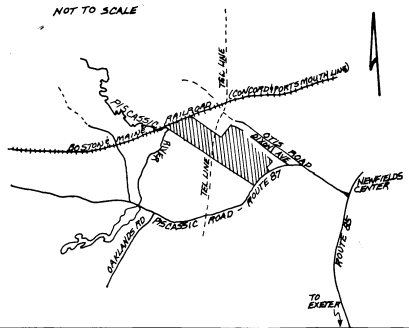

SHEET 1 OF 2 SHEETS



IN  
NEWFIELDS, N. H.

SCALE: 1" = 100' AUGUST 1989\*  
STOCKTON SERVICES  
HAMPTON N.H.



\* NO FIELD WORK OR BOUNDARY SURVEY BY STOCKTON SERVICES.  
THIS PLAN IS A REDRAFT OF "PLAN OF LAND FOR ROSE M.  
SCANLON & EDWARD T. SCANLON IN NEWFIELDS N.H. SEABOARD 1/400,  
JUNE 1980, PARKER SURVEY ASSOC. INC. EXETER & SEABOARD, NH."  
A.C.R. PLAN 01/1446. SHEETS 1 & 2. ALL INFORMATION  
PROVIDED AS IS. NO WARRANTY IS GIVEN. PLAN EXCEPT FOR  
REVISIONS NOTED. REVISIONS TO SHEET 2 INCLUDE TRACT AREA, TITLE  
BLOCK, OMISSION OF LOT 13 (CONVEYED TO W.R. & D.M. DAWSON  
RCA 2377-0444), AND ADDITIONS AND DELETIONS WITHIN  
AREAS OUTLINED REVISIONS TO SHEET 1 INCLUDE TRACT AREA, TITLE  
BLOCK, AND SHOWN AS REVISIONS ON A.C.R. PLAN #0274.  
REQUIRED CALCULATIONS BASED ON RECORD PLANS WERE IN NOTES.


NOTE A: HATCHED PORTIONS OF NELSON AVE., MASON ROAD AND  
DIXON AVE. TO BE DEEDED TO TOWN OF NEWFIELDS.  
TITLE TO ALL OTHER ROADWAY AREAS OUTLINED ON  
THIS PLAN MAY BE DEEDED TO TOWN OF NEWFIELDS, SCANLON  
AND COMBINED WITH REMAINING LAND AS HEREIN  
SHOWN. NO CREATION OF NEW RIGHTS, OR ELIMINATION  
OF ANY EXISTING LEGAL RIGHTS OF ACCESS TO ABUTTING  
PROPERTIES IS INTENDED OR IMPLIED.

NOTE B: REFERENCED TO PLAN OF ROSE M. SCANLON  
TO EDWARD T. SCANLON, JULY 22, 1985.

NOTE 1 : SEE "LAND OF HENRY & LOUIS W. PHINNEY IN  
NEWFIELDS, N.H. AREA: 200 ACRES SCALE 1/4"=200FT. DEC. 8, 1955  
J. LEVITT CRAM, CIVIL ENGINEERS PLAN NO. 02798"

NOTE 2 : SEE "SECTIONS 1, 2 AND 3 OF NEWFIELDS GARDENS IN  
NEWFIELDS, N.H. SCALE: 1/4"= 80FT. AUG. 10, 1957  
J. LEVITT CRAM, CIVIL ENGINEER PLAN NO. 02746."

NOTE 3 : SEE "SECTIONS 1 AND 2 OF NEWFIELDS GARDENS IN NEWFIELDS, N.H.  
SCALE: 1/4"= 80FT. APRIL 8, 1956 J. LEVITT CRAM, CIVIL ENGINEER  
PLAN NO. 027345"

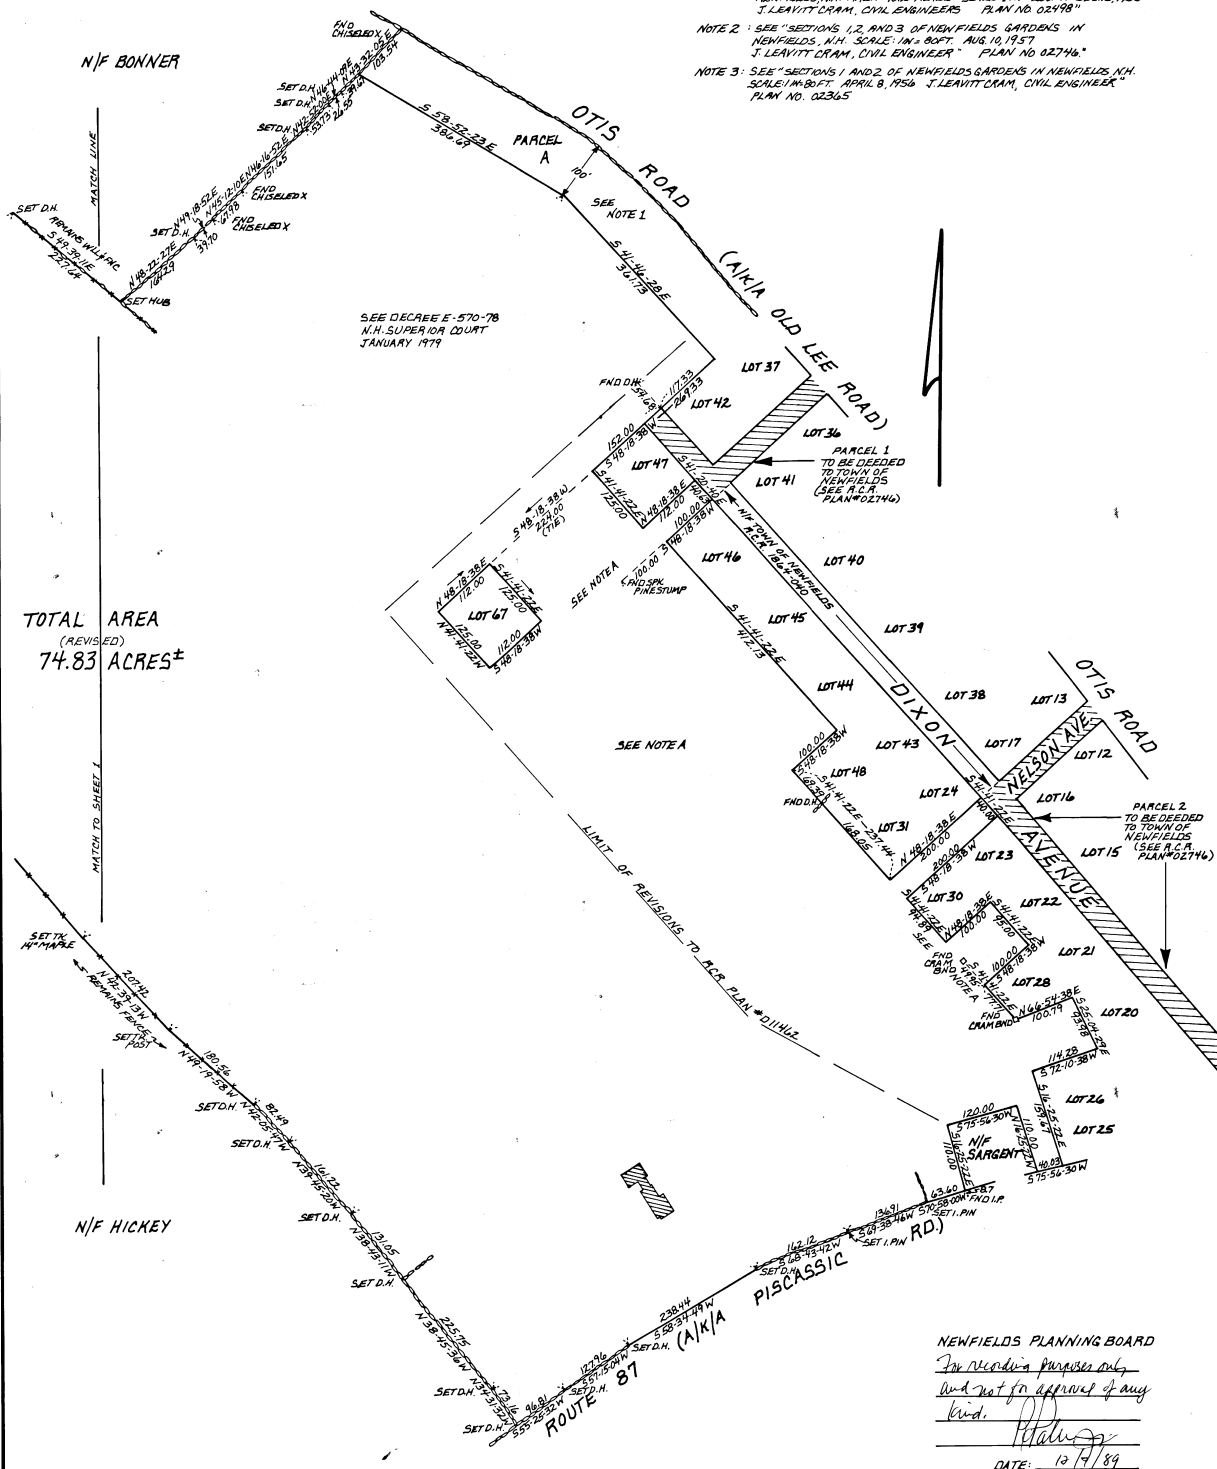

NEWFIELDS PLANNING BOARD  
For recording purposes only,  
and not for approval of any  
kind.  
PPalmer  
DATE: 12/7/89